

Patent
ISE13

REMARKS

Applicants respectfully request that the foregoing amendments be entered before examination of the above-captioned application. FIG. 3 has been removed from the drawings. The additional amendments are made in view of the removal of FIG. 3. The Examiner is respectfully requested to approve the proposed drawings changes and replacement figures.


CONCLUSION

On the basis of the above, early allowance of the application is believed to be warranted and such action is respectfully requested. If the Examiner has any questions or comments regarding this amendment, a telephone call to the undersigned at the number listed below is respectfully urged.

Respectfully submitted,


Dated: 4/18/09

By:

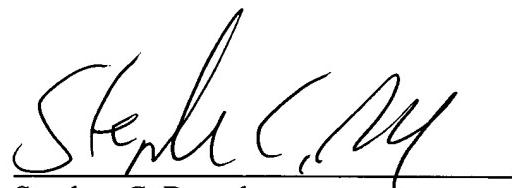

Stephen C. Beuerle
Reg. No. 38,380

Procopio, Cory, Hargreaves & Savitch LLP
530 B Street, Suite 2100
San Diego, California 92101-4469
(619) 238 1900

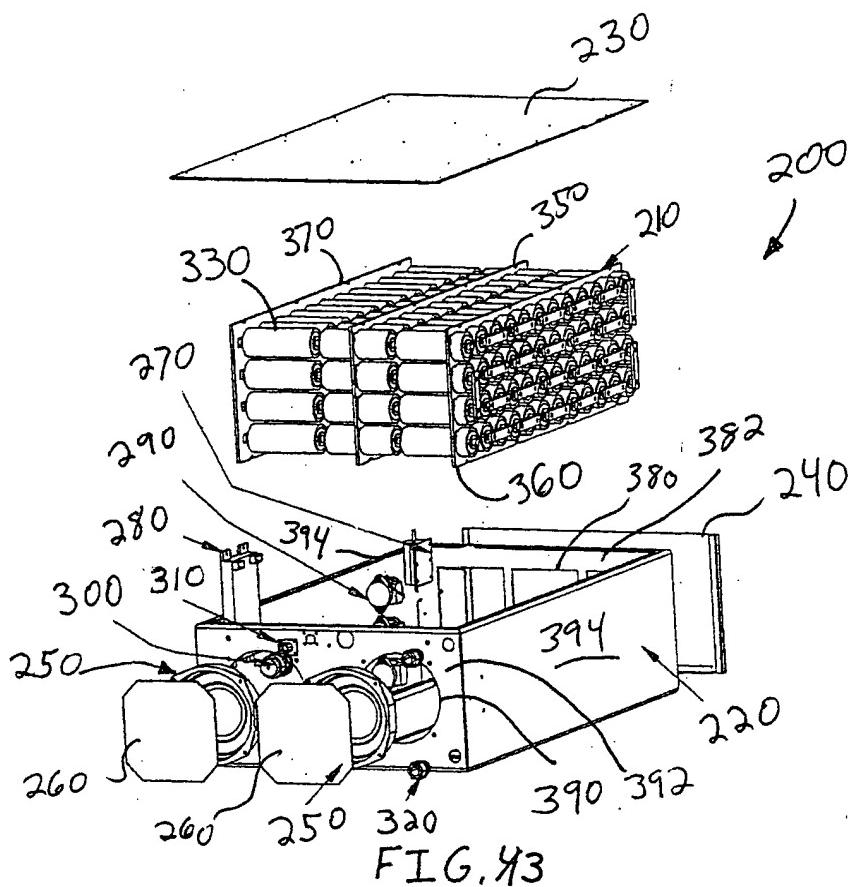

Redlined Drawings

Sht 1 of 4

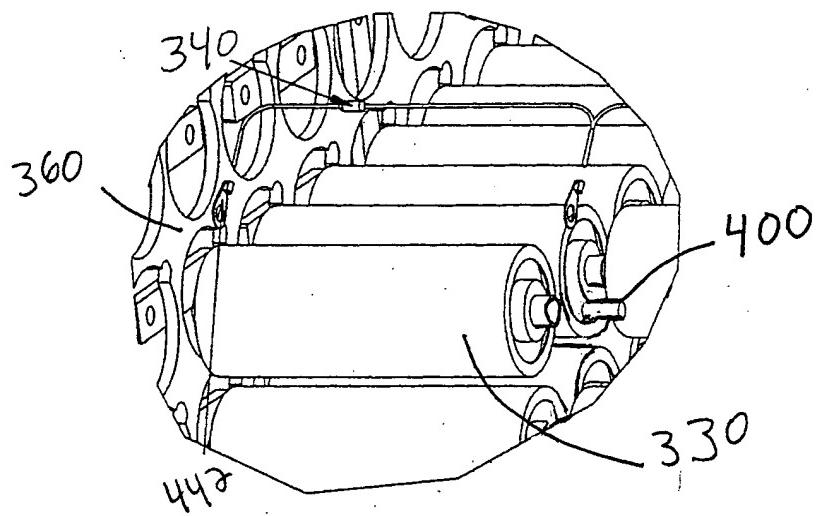
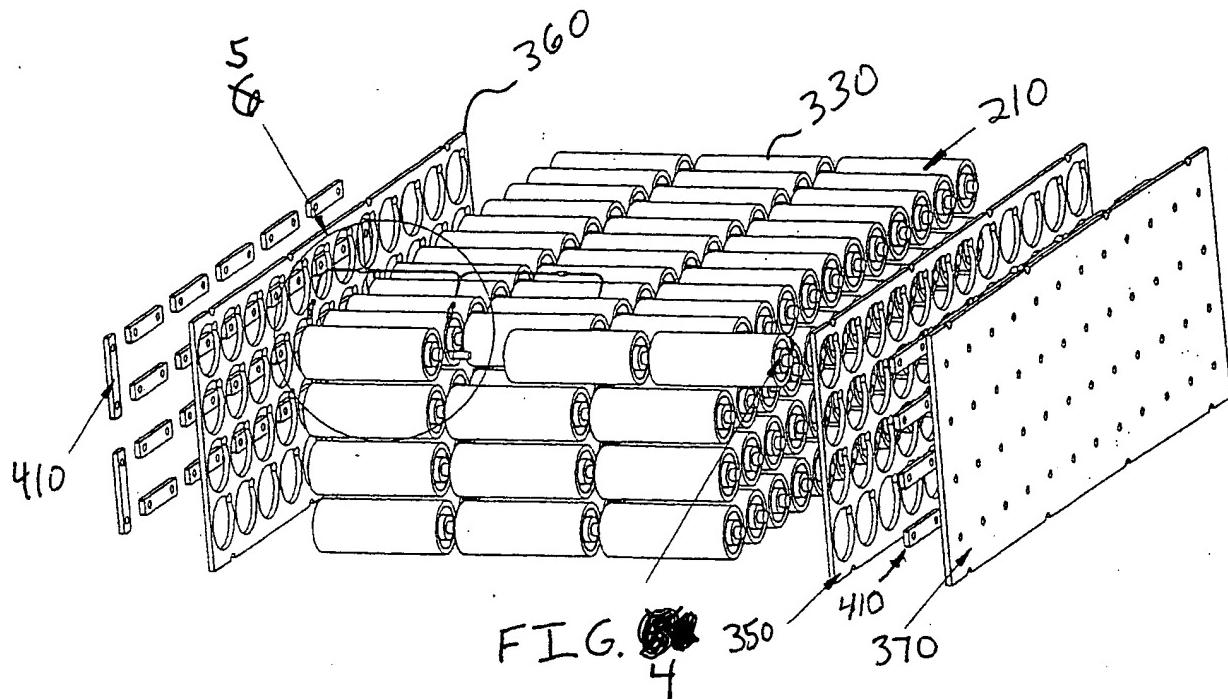
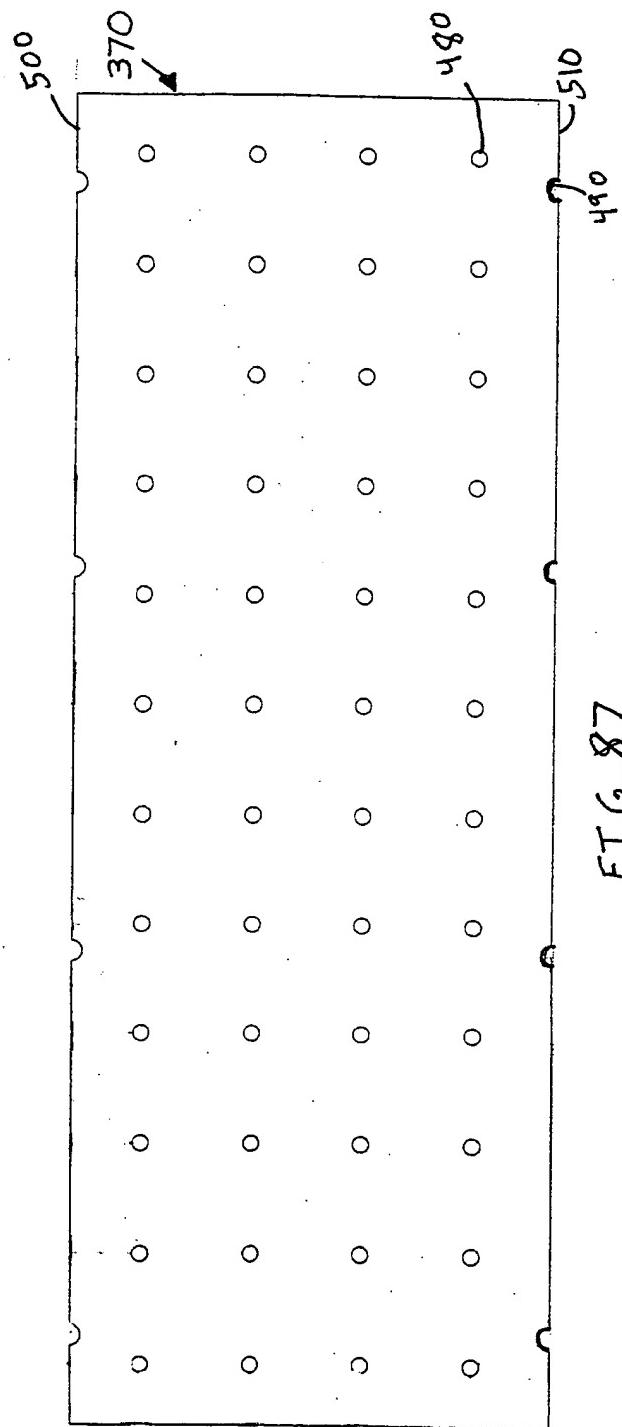
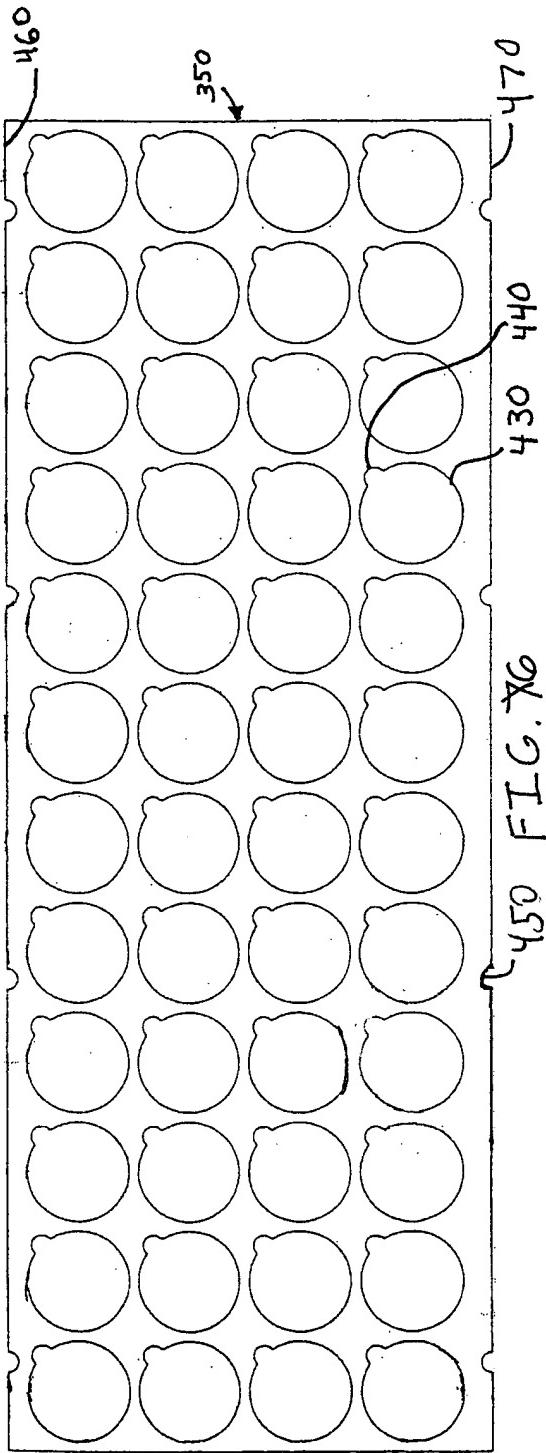


FIG. 65



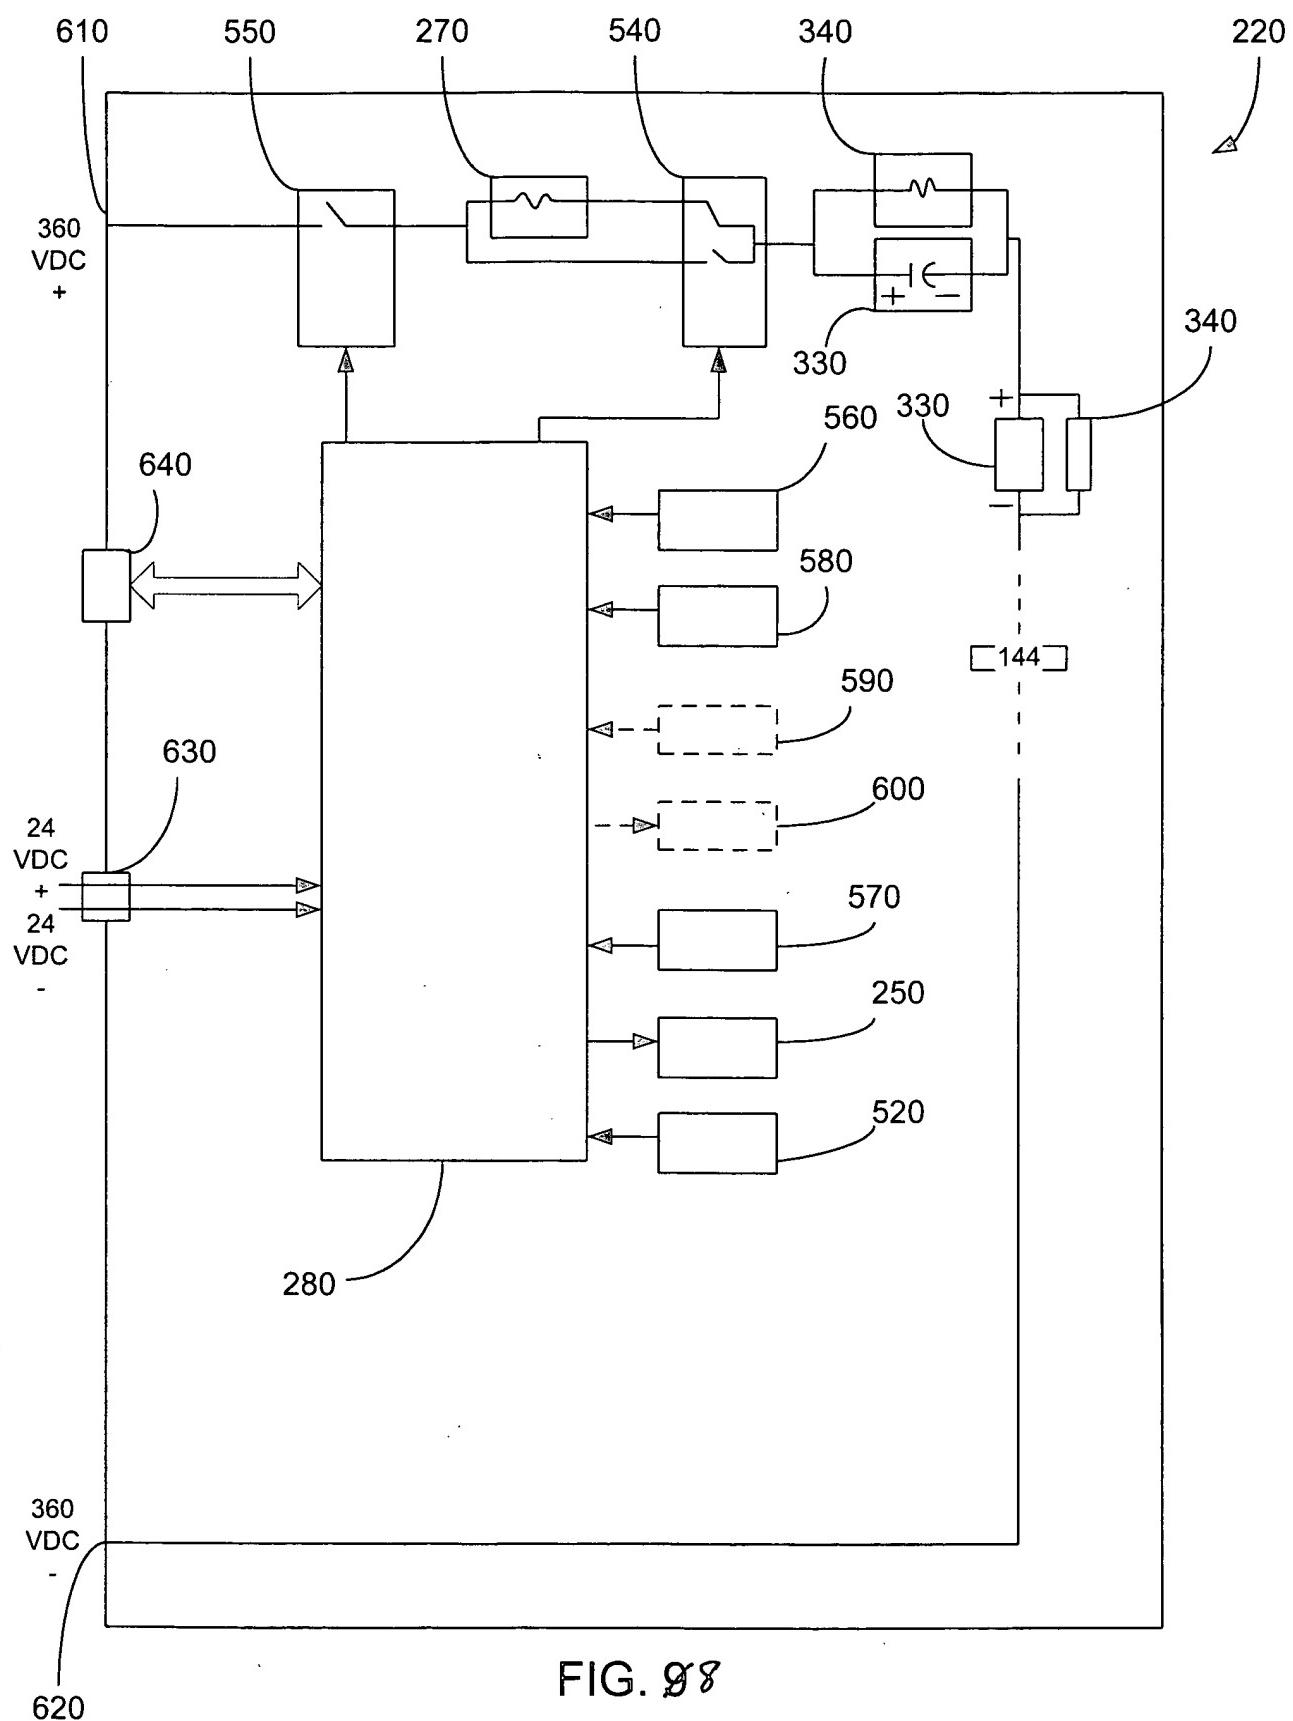


FIG. 98